# MEASUREMENT BOOK

| Date | Full description, etc, of work | Dimensions | | | | Contents | Reference to last Measurement |
|---|---|---|---|---|---|---|---|
| | | Number | Length | Breadth | Depth | | |
| 1 | 2 | 3 | 4 | 5 | 6 | 7 | 8 |
| | | | | | | | |

**M. A. R. 57 (Rule 116)**
Measurement Book

**No. E** 486711

Serial No. .....

Name of work ..... From ..... To .....

Name of Contractor of nature of Agency.....

Date of commencement of work.....

| Date | Full description, etc, of work | Dimensions | | | | Contents | Reference to last Measurement |
|---|---|---|---|---|---|---|---|
| | | Number | Length | Breadth | Depth | | |
| 1 | 2 | 3 | 4 | 5 | 6 | 7 | 8 |
| | Name of work :- Constion of CC Road and other works ~~At Bbijne~~ Colony balance road in ward No.12 Shettihalli | | | | | | |
| | Estimated Cost :- Rs 150.00 Lakhs. | | | | | | |
| | Code sheet No :- 012-20-000012 | | | | | | |
| | Administration Approval :- No/BBMP/DD/EE/168/2019-20 | | | | | | dtd 14.11.2019 |
| | Technical sanction :- No/BBMP/DZ/CE/59/2019-20 | | | | | | dtd 16.11.2019 |
| | contractor :- M/s KRIDL B'lore | | | | | | |
| | Work order No. :- No/EE/DD/WO/313/2019-~~20~~ dtd. 19.11.2019. 08/03/21 | | | | | | |

# MEASUREMENT BOOK

| Date | Full description, etc, of work | Dimensions | | | | Contents | Reference to last Measurement |
|---|---|---|---|---|---|---|---|
| | | Number | Length | Breadth | Depth | | |
| 1 | 2 | 3 | 4 | 5 | 6 | 7 | 8 |
| Sl No. | Description of Item | Unit | Qty | Rate | | Amount | Remarks. |
| 1 | ERSE | Cum | 661.08 | 137.80 | | 91096.82 | |
| 2 | CC 1:3:6 Court | Cum | 104.69 | 5714.97 | | 598300.21 | |
| 3 | RCC M25 Court. | Cum | 143.20 | 5775.37 | | 827032.98 | |
| 4 | TMT Steel. | MT | 6.20 | 72326.98 | | 448427.28 | |
| 5 | Removal Rendy Slab | Sqm | 298.58 | 208.82 | | 62349.48 | |
| 6 | Ruled pointing 20mm dip | Sqm | 165.88 | 49.06 | | 8138.07 | |
| 7 | 100mm Thick Cc Slab | Sqm | 1049.78 | 1615.00 | | 1692164.70 | |
| 8 | Scarifying BC | Sqm | 445.37 | 41.34 | | 17339.60 | |
| 9 | Scarifying Metal Cnt | Sqm | 3852.60 | 25.44 | | 98010.14 | |
| 10 | Computation of OGL | Sqm | 4044.68 | 6.36 | | 25722.89 | |
| 11 | DLC, | Cum | 404.45 | 3946.51 | | 1595357.07 | |
| 12 | DMM, | Cum | 404.45 | 2001.28 | | 809417.70 | |

08/03/2024

M. A. R. 57 (Rule 116)
Measurement Book

No. E 486712

Serial No. .....

Name of work ..... From ..... To .....

Name of Contractor of nature of Agency.....

Date of commencement of work.....

| Date | Full description, etc, of work | Dimensions | | | | Contents | Reference to last Measurement |
|---|---|---|---|---|---|---|---|
| | | Number | Length | Breadth | Depth | | |
| 1 | 2 | 3 | 4 | 5 | 6 | 7 | 8 |
| 13 | PQC M30 Court | Cum | 647.12 | 5354.12 | | 3466693.42 | |
| 14 | Kerb. | No's | 2488.22 | 435.84 | | 1084468.80 | |
| 15 | Kerb painting | Sqm | 249.60 | 8.80 | | 2196.08 | |
| 16 | Unserviceable Soil Remove | Cum | 661.08 | 34.98 | | 23124.58 | |
| 17 | Hauling Cartage & incl | Cum | 669.60 | 57.00 | | 38167.20 | |
| 18 | Filling Excluding Lead | Cum | 1330.68 | 51.28 | | 68237.27 | |
| 19 | Fly Ash Filling 40mm Jelly | Cum | 1.24 | 1901.00 | | 2357.24 | |
| 20 | Fly Filling 20mm Jelly | Cum | 1.24 | 1901.00 | | 2357.24 | |
| 21 | Fly Filling Course Sand | Cum | 0.93 | 2651.00 | | 2465.43 | |
| 22 | Filling Fashion Fine Sand | Cum | 0.62 | 2651.00 | | 1643.62 | |

08/03/2024

# MEASUREMENT BOOK

| Date | Full description, etc, of work | Dimensions | | | | Contents | Reference to last Measurement |
|---|---|---|---|---|---|---|---|
| | | Number | Length | Breadth | Depth | | |
| 1 | 2 | 3 | 4 | 5 | 6 | 7 | 8 |
| 23 | Filly foundation 12-5mm chipp | Cum | 0.93 | 1901.00 | | 1767.93 | |
| 24 | HDPE Pipe | Rmt. | 18.00 | 10822.32 | | 194801.76 | |
| 25 | Geonets | Sqm | 3.10 | 71.03 | | 220.19 | |
| | | | | Total = | | 11332854.71 | |
| | Add 12.00% GST chgs | | | = | | 1359942.57 | |
| | Add 4% KRIDL charges | | | = | | 453314.19 | |
| | | | | Grand Total = | | 1,31,46,111=46. | |

ಸಹಾಯಕ ಕಾರ್ಯನಿರ್ವಾಹಕ ಅಭಿಯಂತರರು
ಶೆಟ್ಟಿಹಳ್ಳಿ ಉಪವಿಭಾಗ [illegible]
ಬೃಹತ್ ಬೆಂಗಳೂರು [illegible]
ಎಸ್.ಎಂ. ರಸ್ತೆ, ರಾಜಾಜಿನಗರ

7 (Rule 116)
ment Book

No. E 486713

Serial No. .....
Name of work ..... From ..... To .....
Name of Contractor of nature of Agency.....
Date of commencement of work.....

| Date | Full description, etc, of work | Dimensions | | | | Contents | Reference to last Measurement |
|---|---|---|---|---|---|---|---|
| | | Number | Length | Breadth | Depth | | |
| 1 | 2 | 3 | 4 | 5 | 6 | 7 | 8 |

Audited and admitted for Rs. 1314611=46
Passed by Cheque for Rs. 1159464=46
One Crore Fifteen Lakh Ninety Four Thousand Six Hundred Sixty Eight only
by adjustment Rs. 155147=63

Accounts Superintendent
Exe. Engineer
B.B.M.P. Dasarahalli Division

# MEASUREMENT BOOK

| Date | Full description, etc, of work | Dimensions | | | | Contents | Reference to last Measurement |
|---|---|---|---|---|---|---|---|
| | | Number | Length | Breadth | Depth | | |
| 1 | 2 | 3 | 4 | 5 | 6 | 7 | 8 |

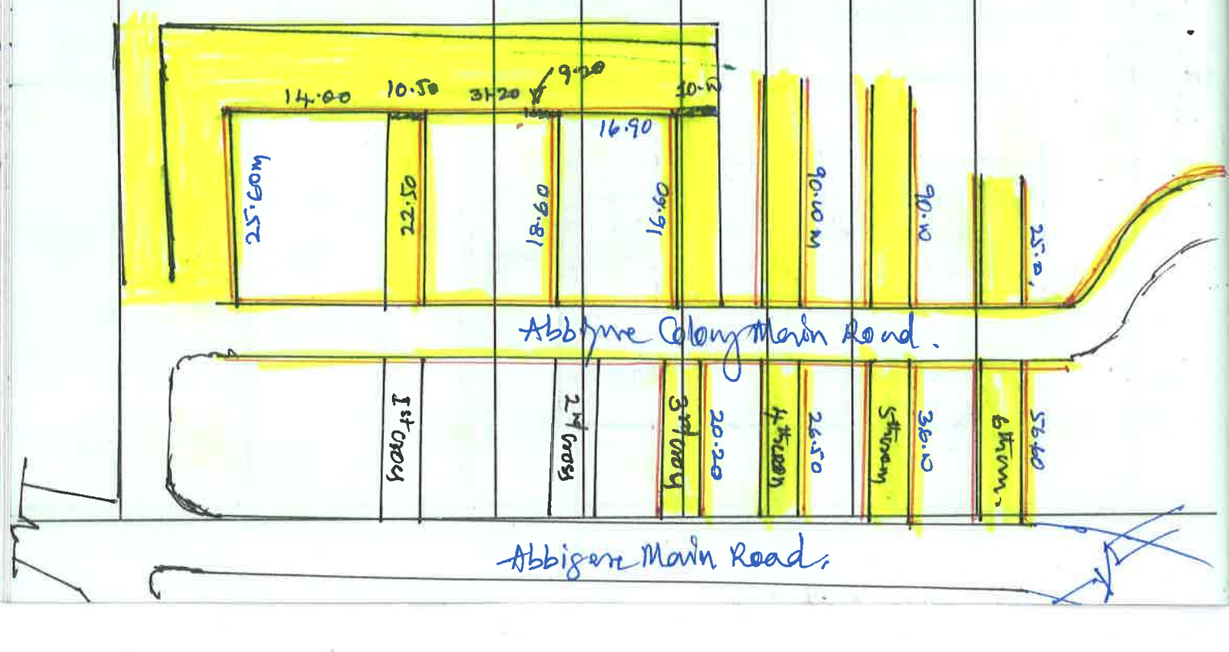


**M. A. R. 57 (Rule 116)**
Measurement Book

No. E 486714

Serial No. .....

Name of work ..... From ..... To .....

Name of Contractor of nature of Agency.....

Date of commencement of work.....

| Date | Full description, etc, of work | Dimensions | | | | Contents | Reference to last Measurement |
|---|---|---|---|---|---|---|---|
| | | Number | Length | Breadth | Depth | | |
| 1 | 2 | 3 | 4 | 5 | 6 | 7 | 8 |

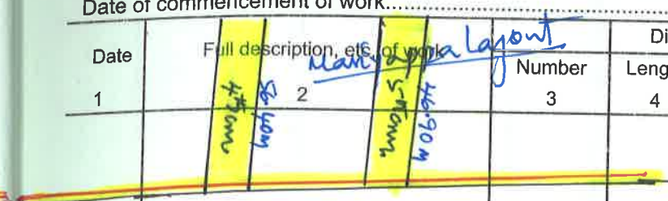


08/03/21

ಸಹಾಯಕ ಕಾರ್ಯಪಾಲಕ ಅಭಿಯಂತರರು
ಕೆಂಪಹಳ್ಳಿ ಉಪ ವಿಭಾಗ, ಹೊಸರಹಳ್ಳಿ ವಲಯ
ಬೃಹತ್ ಬೆಂಗಳೂರು ಮಹಾನಗರ ಪಾಲಿಕೆ
ಎಸ್.ಎಂ. ರಸ್ತೆ, ರವೀಂದ್ರನಗರ, ಬೆಂಗಳೂರು.